


SUITE 103
The Timbers
445 Marine View Drive
Del Mar, CA 92014

09.08.2009

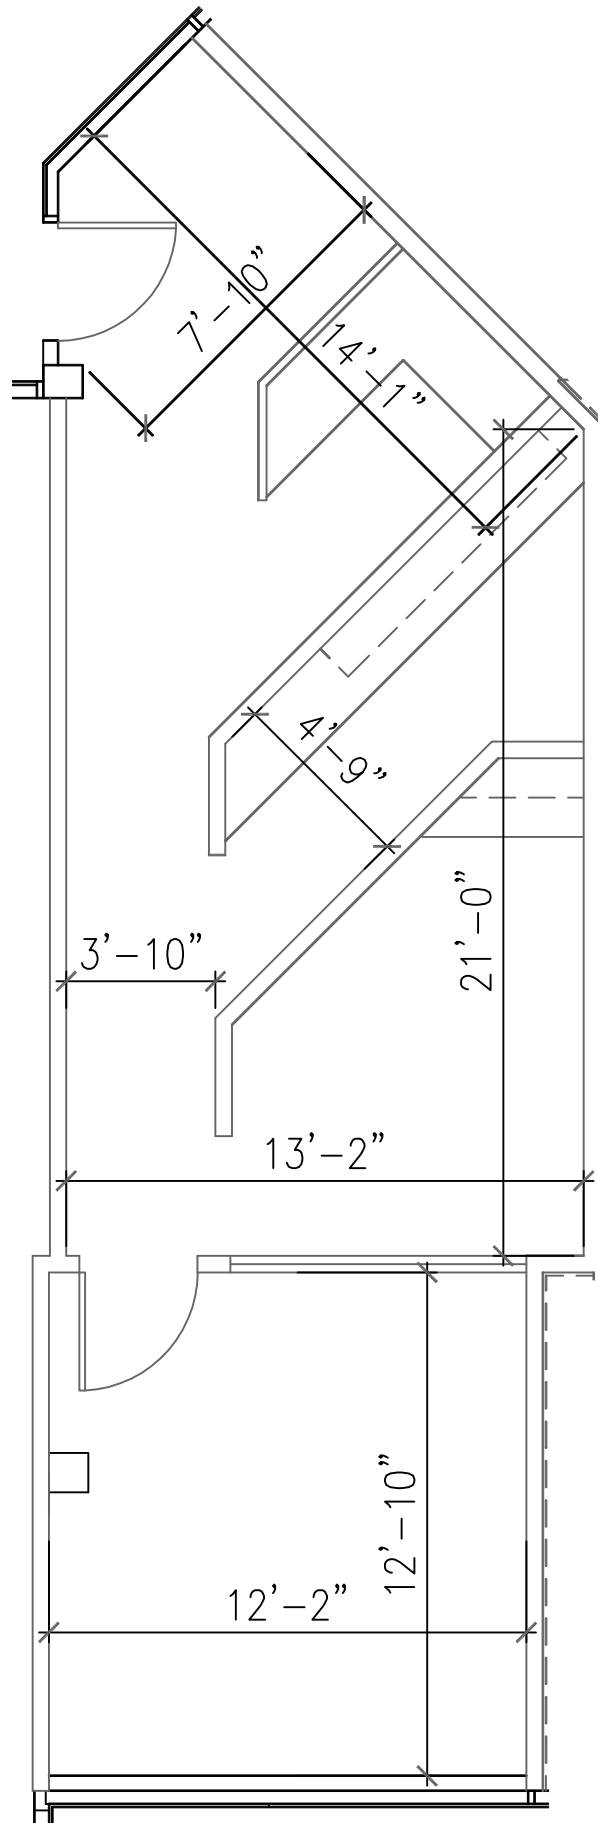

SPACE PLAN

SCALED TO FIT