


09.08.2009

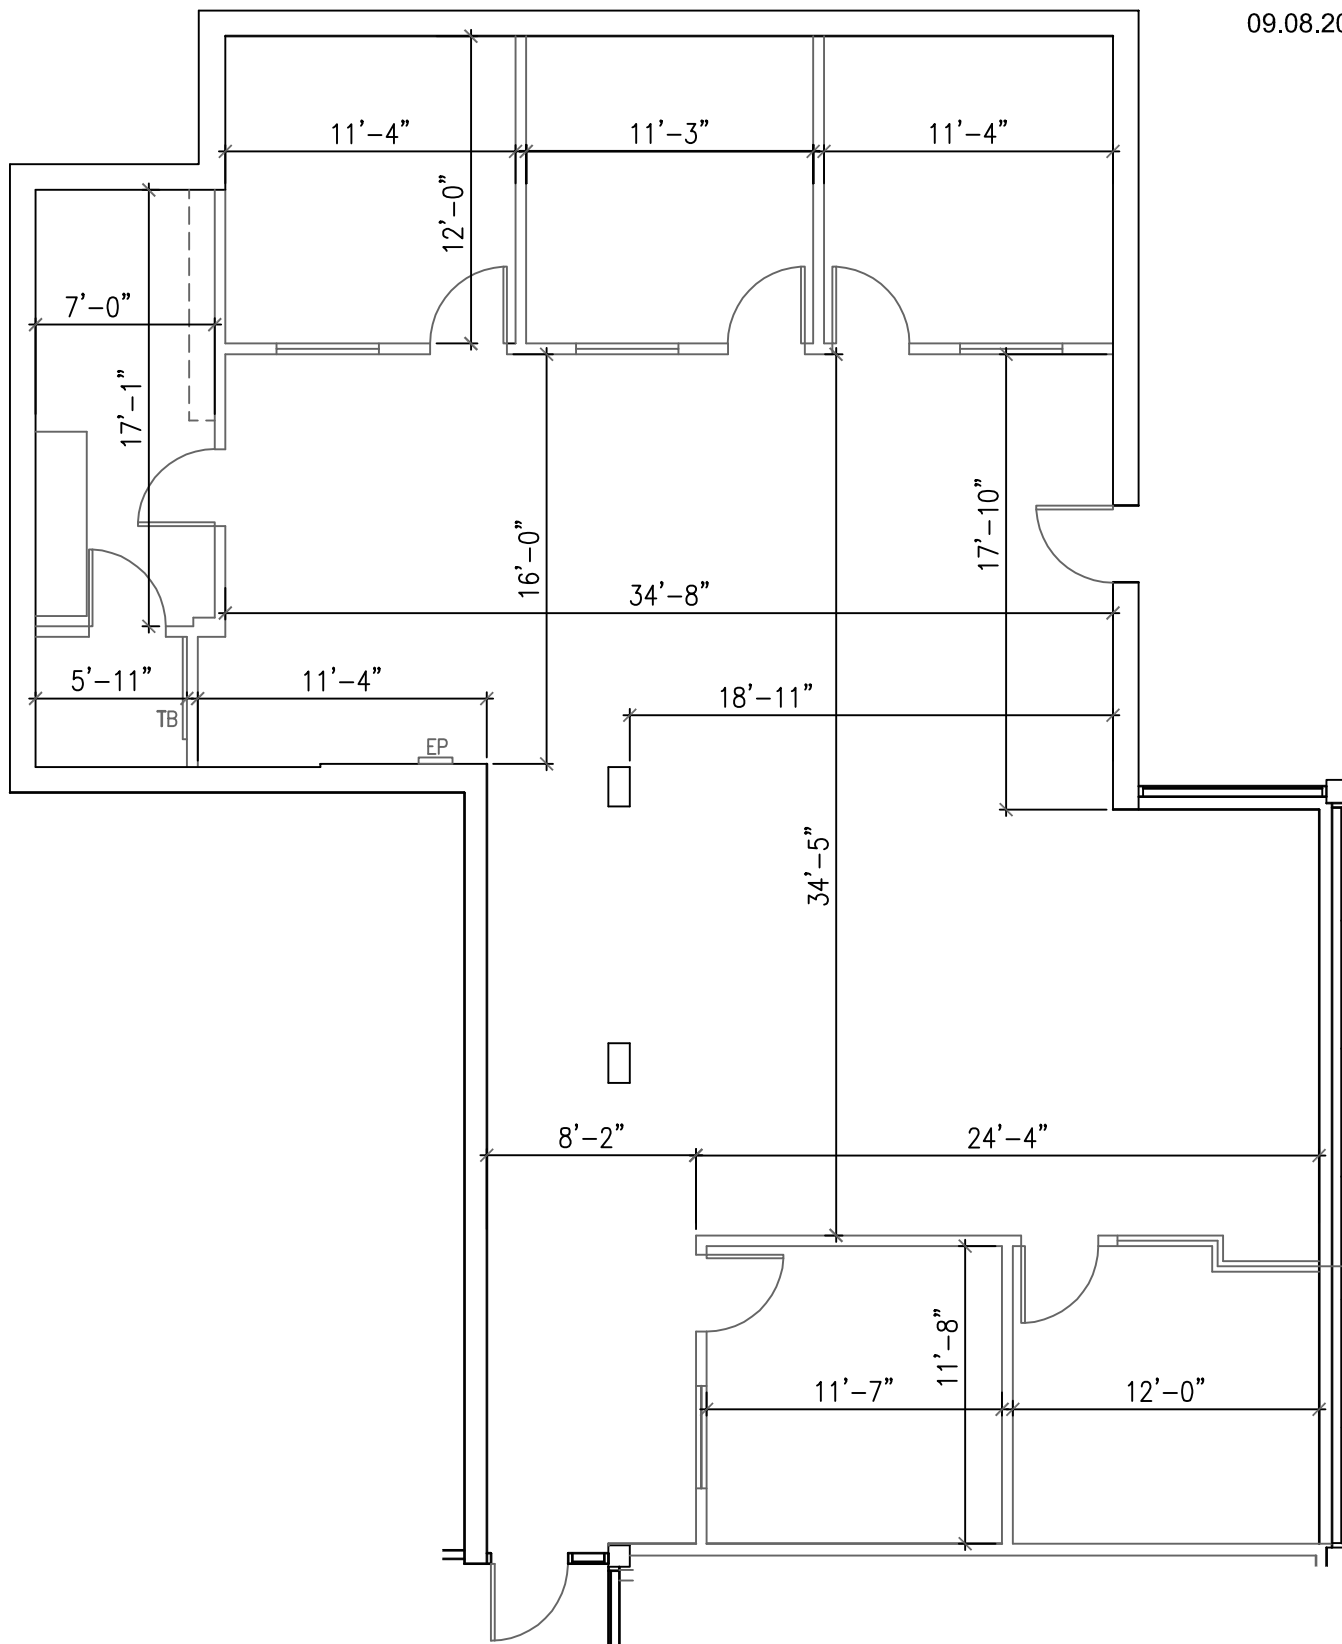

SPACE PLAN

SCALED TO FIT