


**SUITE 260**  
The Timbers  
445 Marine View Drive  
Del Mar, CA 92014

09.08.2009

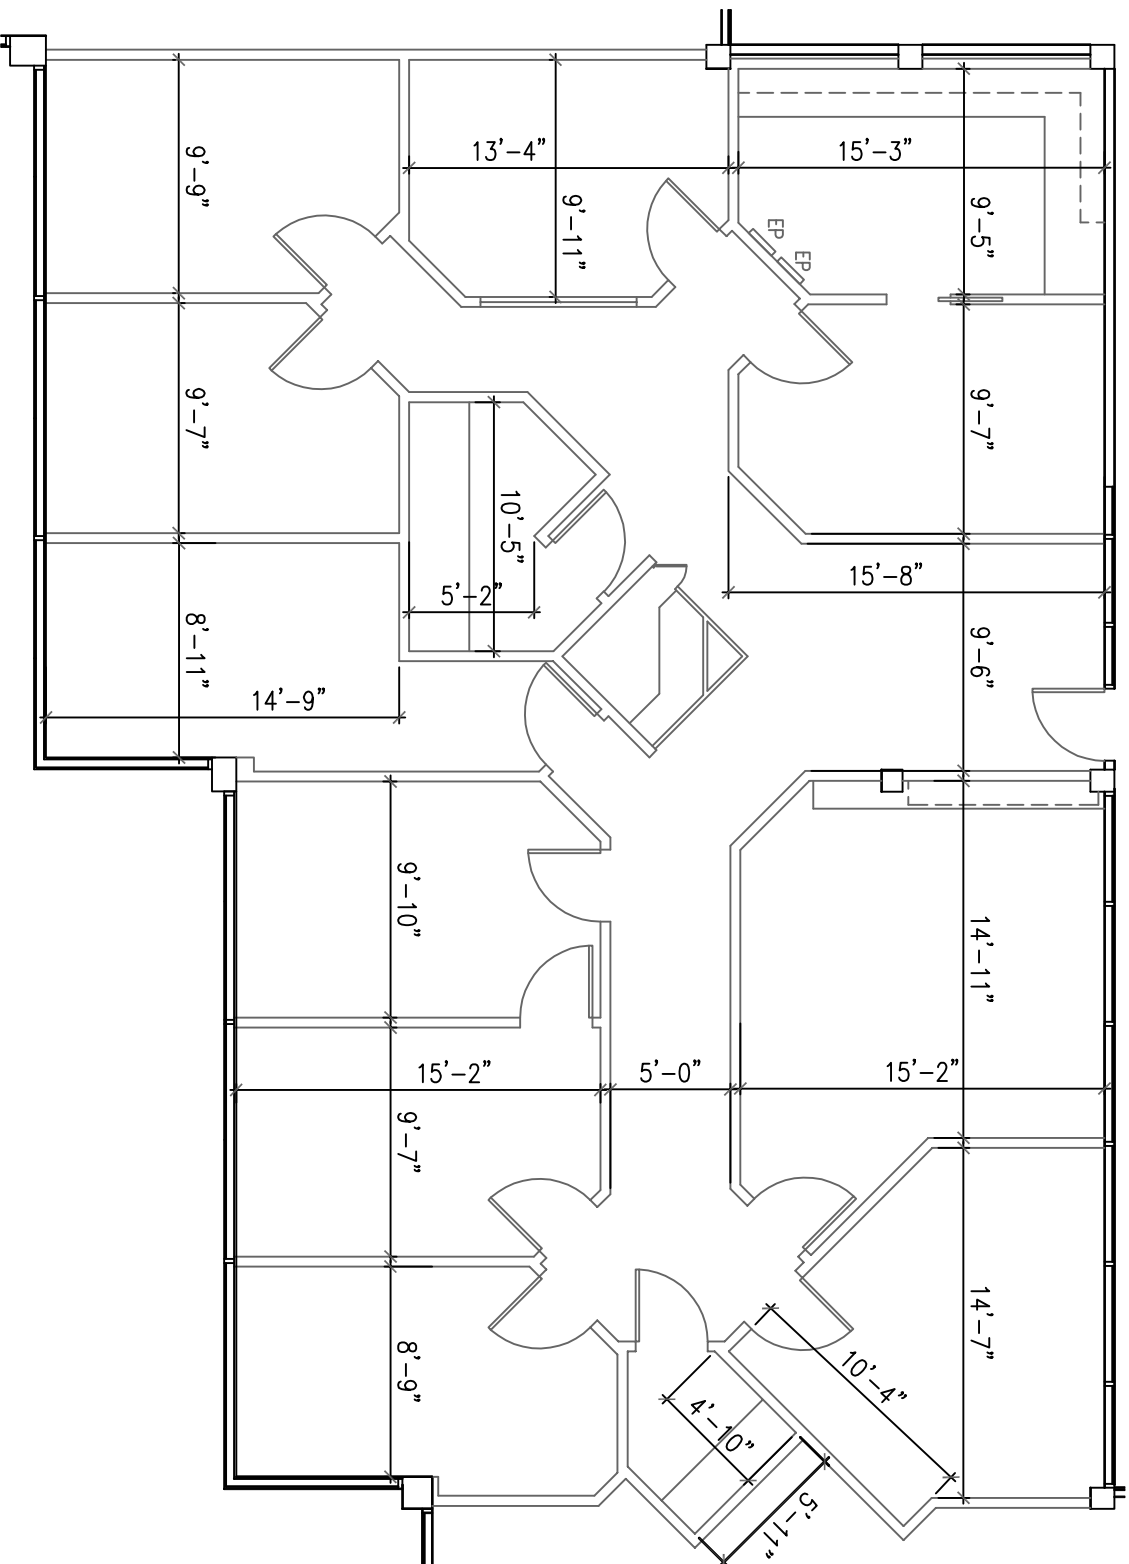

# SPACE PLAN

SCALED TO FIT